

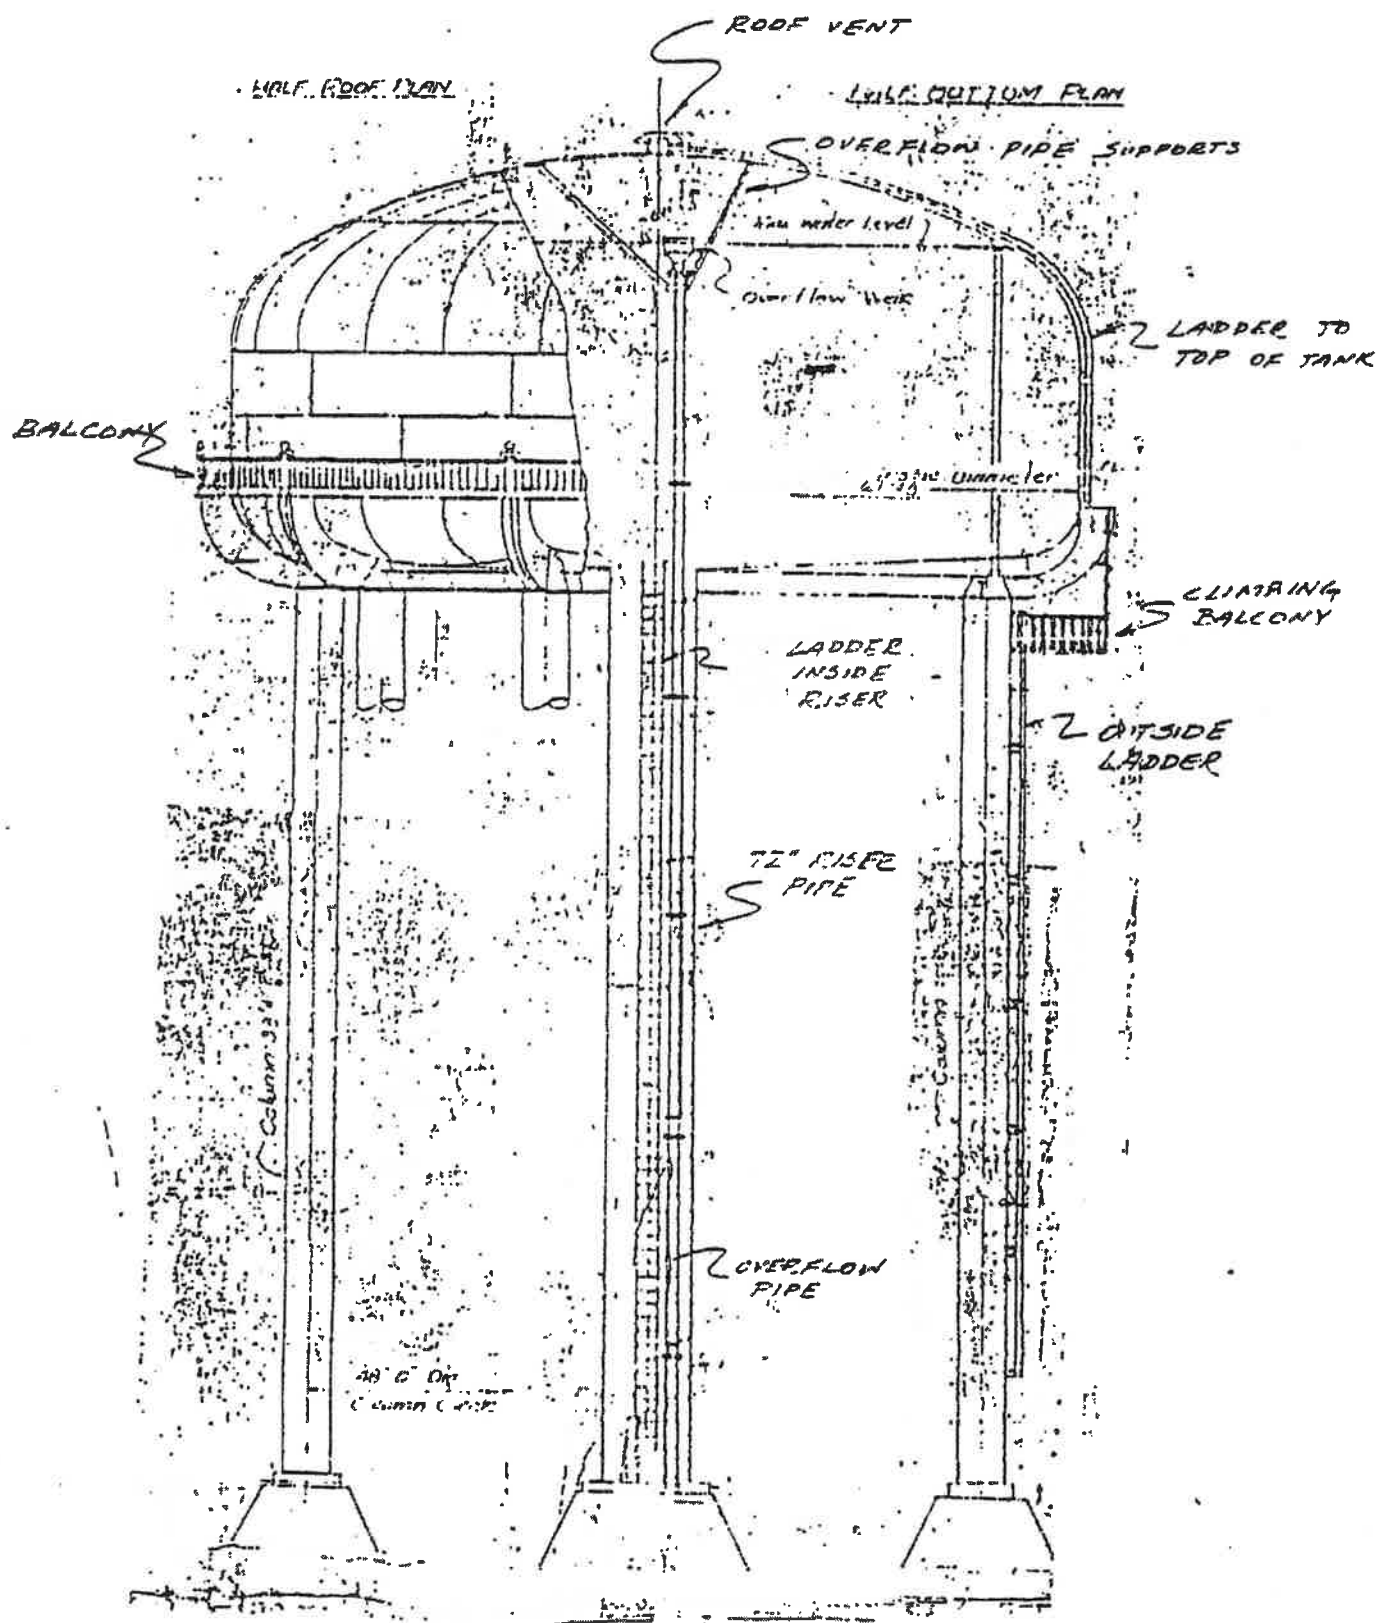


AS BUILT DRAWINGS FOR DECATUR TANK

FILTER PLANT SYSTEM FACILITIES OPERATIONAL MANUAL GENERAL SYSTEM DECATUR ELEVATED TANK

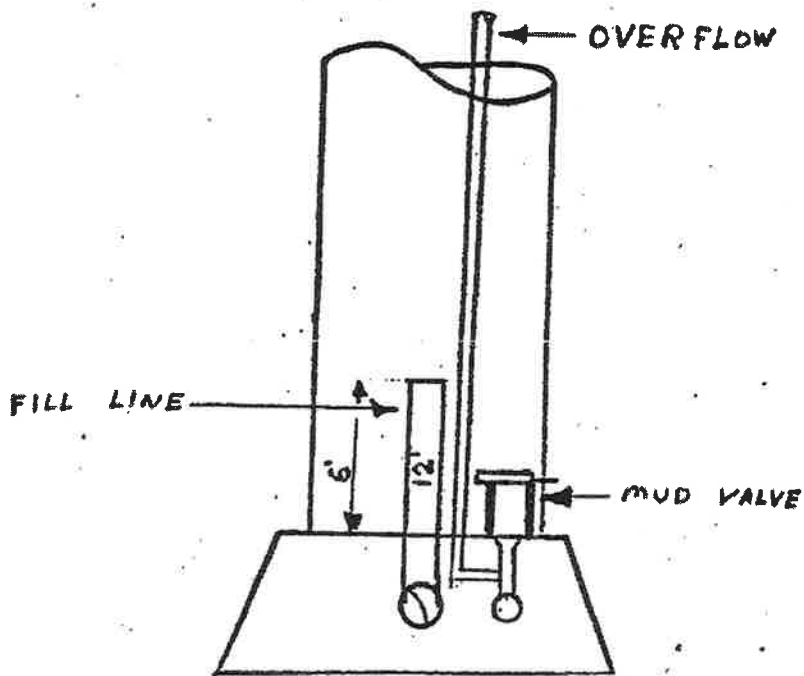

Decatur TANK- AS-BUILT (JUNE, 1968)

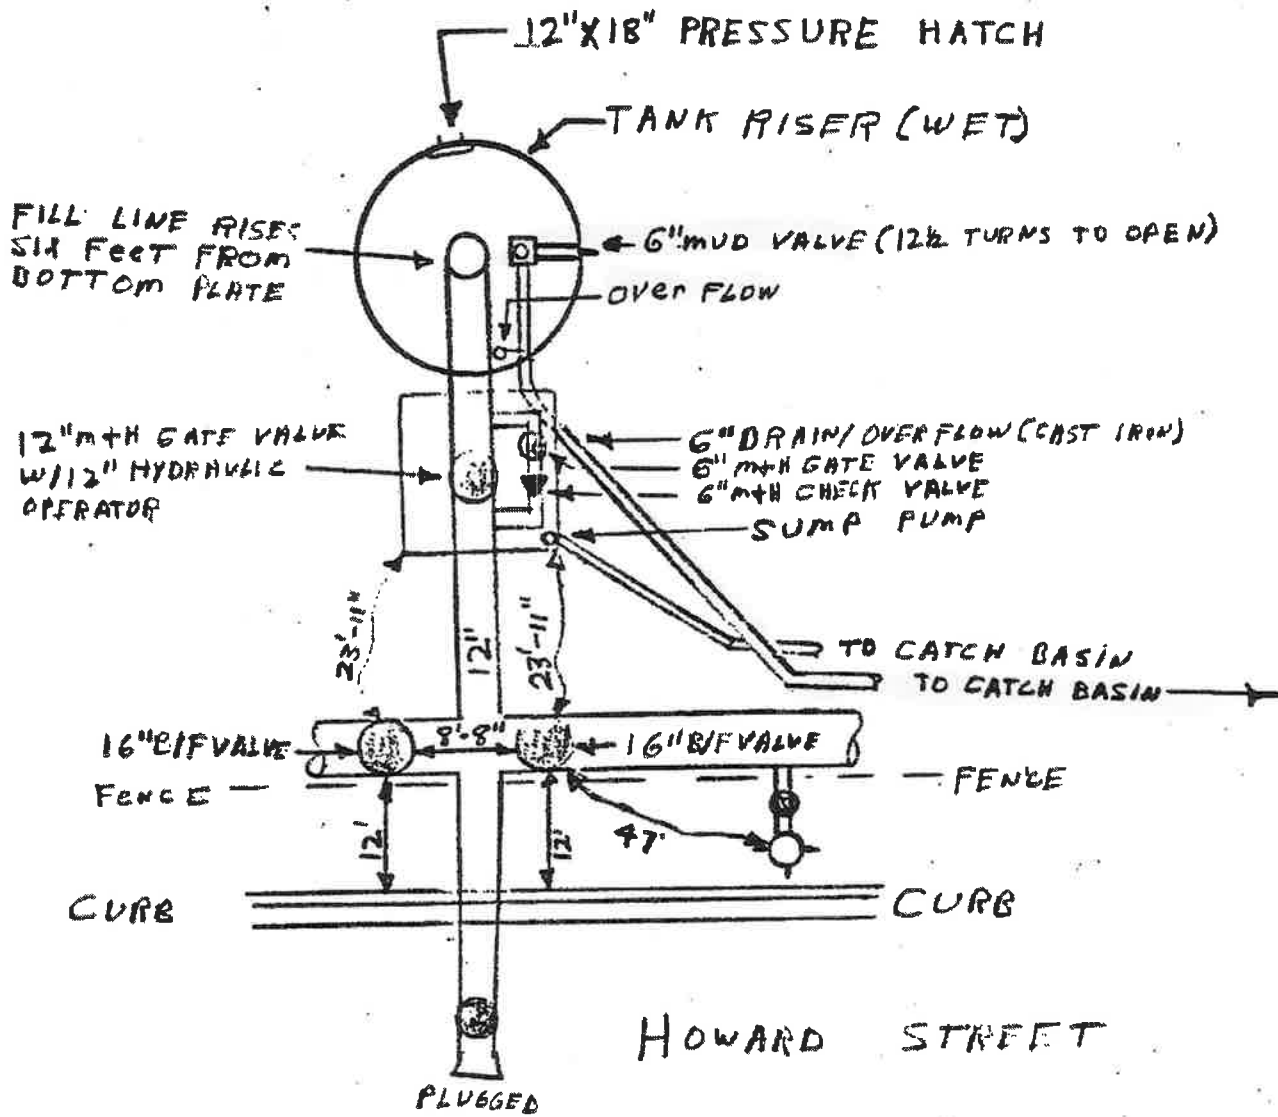

NOT TO SCALE