



Government Services Center
178 Sams Street
Decatur, GA 30030
www.dekalbcountyga.gov/planning
404-371-2155 (o); 404-371-4556 (f)

Chief Executive Officer
Michael Thurmond

DEPARTMENT OF PLANNING & SUSTAINABILITY

Interim Director
Cedric Hudson

Application for Certificate of Appropriateness

Date Received: 12/11/2023 Application No.: _____
Address of Subject Property: 2081 East Lake Road, Atlanta GA 30307
Applicant: Alair Homes Decatur E-Mail: heather.shuster@alairhomes.com
Applicant Mailing Address: 619 East College Avenue, Suite D-1, Decatur, GA 30030

Applicant Phone: 678-362-7895 Fax: _____

Applicant's relationship to the owner: Owner ☐ Architect: ☐ Contractor/Builder ☒ Other ☐

Owner(s): Brittney Gove Email: brittgove@gmail.com
Owner(s): Matt Gove Email: mattgove3@gmail.com
Owner(s) Mailing Address: 2081 East Lake Road, Atlanta, GA 30307
Owner(s) Telephone Number: 404-405-4265

Approximate age or date of construction of the primary structure on the property and any secondary structures affected by this project:
Built 2001

Nature of work (check all that apply):

New construction ☐ Demolition ☐ Addition ☒ Moving a building ☐ Other building changes ☐ New accessory building ☐ Landscaping ☐ Fence/Wall ☐ Other environmental changes ☐ Sign installation or replacement ☐ Other ☒

Description of Work:

Nonhistoric property.

Homeowner wishes to add new pool and screen porch to rear of home.

All work will not be visible from the street.

This form must be completed in its entirety and be accompanied by supporting documents, such as plans, list of materials, color samples, photographs, etc. All documents should be in PDF format, except for photographs, which may be in JPEG format. Email the application and supporting material to plansustain@dekalbcountyga.gov and pvjennings@dekalbcountyga.gov. An incomplete application will not be accepted.

Signature of Applicant: _____

DEPARTMENT OF PLANNING & SUSTAINABILITY

Authorization of a Second Party to Apply for a Certificate of Appropriateness

This form is required if the individual making the request is **not** the owner of the property.

I/ We: Brittney & Matt Gove
being owner(s) of the property at: 2081 East Lake Road, Atlanta, GA 30307
hereby delegate authority to: Alair Homes Decatur
to file an application for a certificate of appropriateness in my/our behalf.

Signature of Owner(s):  
Date: December 8, 2023 

Please review the following information

Approval of this Certificate of Appropriateness does not release the recipient from compliance with all other pertinent county, state, and federal regulations.

Before making any changes to your approved plans, contact the preservation planner (404/371- 2155). Some changes may fall within the scope of the existing approval, but others will require review by the preservation commission. If work is performed which is not in accordance with your certificate, a Stop Work Order may be issued.

If your project requires that the county issue a Certificate of Occupancy at the end of construction, an inspection may be made to verify that the work has been completed in accord with the Certificate of Appropriateness. If the work as completed is not the same as that approved in the Certificate of Appropriateness you will not receive a Certificate of Occupancy. You may also be subject to other penalties including fines and/or required demolition of the non-conforming work.

If you do not commence construction within twelve months of the date of approval, your Certificate of Appropriateness will become void and you will need to apply for a new certificate if you still intend to do the work.

DEPARTMENT OF PLANNING & SUSTAINABILITY

DEKALB COUNTY HISTORIC PRESERVATION COMMISSION 2023 Calendar

This calendar is subject to change. Please visit the [Department of Planning and Sustainability](https://www.dekalbcountyga.gov/planning-and-sustainability) website for the current calendar, agenda, and applications.

<u>Applications Accepted</u>	<u>Filing Deadline</u>	<u>Sign Must Be Posted</u>	<u>HPC Meeting Date</u>	<u>Last Date to File Appeal (approximate)</u>
December 12	December 23	January 07	January 17	February 02
January 17	January 30	February 11	February 21	March 09
February 13	February 24	March 10	March 20	April 04
March 13	March 24	April 07	April 17	May 02
April 10	April 21	May 05	May 15	May 30
May 15	May 26	June 10	June 20	July 05
June 12	June 23	July 07	July 17	August 01
July 17	July 28	August 11	August 21	September 5
August 14	August 25	September 08	September 18	October 03
September 11	September 22	October 06	October 16	October 31
October 16	October 27	November 03	November 13	December 05
November 13	November 24	December 08	December 18	January 02

Tuesday meeting due to holiday

DEPARTMENT OF PLANNING & SUSTAINABILITY

How to Obtain a Certificate of Appropriateness

1. Contact the DeKalb County Department of Planning and Sustainability for an application form. You may make your request by email plansustain@dekalbcountyga.gov AND rlbragg@dekalbcountyga.gov, telephone (404) 371-2247, or fax (404) 371-2813, or visit the website at <https://www.dekalbcountyga.gov/planning-and-sustainability/forms>
2. Complete and submit the application. Please provide as much supporting material as possible, (plans, material, color samples, photos, etc.). All documents must be in PDF format except for photographs, which may be in JPEG format. Applications are accepted for a 10-day period each month. See page 3 (HPC Calendar). Email the application and supporting documents to plansustain@dekalbcountyga.gov AND rlbragg@dekalbcountyga.gov. If all documents are not provided the application will not be complete and will not be accepted.
3. The Preservation Planner will post a sign on the property at least ten days before the preservation commission meeting or coordinate sign posting with the applicant.
4. The Preservation Planner will visit the property as part of their review. The commission members may view the property from the right-of-way.
5. Applications will be reviewed by the DeKalb County Historic Preservation Commission at its monthly meeting. The Historic Preservation Commission meets on the third Monday at 6 p.m., via Zoom. In unusual circumstances meeting dates and location may be changed.
6. The Historic Preservation Commission may approve, approve with modifications or deny an application. The applicant or any affected person as defined by county code may appeal the decision to the DeKalb County Board of Commissioners. Please contact the Department of Planning and Sustainability if you wish to file an appeal. The Historic Preservation Commission is required to make a decision on an application within 45 days of the date of filing, although this time can be extended if the applicant agrees to a deferral.
7. Although not required, applicants are encouraged to attend the Historic Preservation Commission meetings. Applicants may make a presentation, but presentations are not required. The commissioners may have questions for the applicant.
8. Approval of a Certificate of Appropriateness does not release the recipient from compliance with all other county, state and federal regulations.

DEPARTMENT OF PLANNING & SUSTAINABILITY

Design Checklist for a Certificate of Appropriateness

This checklist was created to help applicants prepare a complete application. Omissions and inaccurate information can lead to deferrals and/or denials of applications. Please review the checklist with the project's architect, designer, or builder. All items will not be applicable to all projects. New construction will involve all categories. One copy of drawings at scale (plus nine reduced sets) should be submitted.

Please address questions regarding applicability to your project to the DeKalb County Preservation Planner at 404-371-2155, e-mail dccullis@dekalbcountyga.gov and rlbragg@dekalbcountyga.gov.

Applicants are also referred to the DeKalb County website, <http://www.dekalbcountyga.gov/planning-and-sustainability/planning-sustainability>.

I have reviewed the "Design Manual for the Druid Hills Local Historic District".	Y _____	N _____
I have reviewed the DeKalb County Tree Ordinance.	Y _____	N _____
I have reviewed applicable zoning codes regarding lot coverage, garage sizes, stream buffers.	Y _____	N _____

1. General

- Label all drawings with the address of the site, owners' name, and contact phone number.
- Number all drawings.
- Include a graphic scale on reductions.
- Date all revisions.
- Indicate all unverified numbers with +/- signs
- Include photos of the existing condition of the property.

2. Site Plan (existing and proposed) to include:

- Topographical plan with significant trees sized and located;
- Setback compared to adjacent houses (ask surveyor to show corners of adjacent houses);
- Distance between houses;
- Façade width to finished face of material;
- Grading and elevations across site;
- Dirt removal or regrading if more than 18";
- Tree protection plan;
- Tree removal and replacement plan

3. Driveways and Walkways

- Location and relationship to house;
- Width;
- Material;
- Curb cut and apron width

DEPARTMENT OF PLANNING & SUSTAINABILITY

4. Fences & Retaining Walls

- a. Placement on lot;
- b. Height of fence or wall. If retaining wall, height on both sides;
- c. Material;
- d. Railing if necessary

5. Elevations and Floor Plans: <<Indicate all unverified numbers with +/- signs>>

- a. Plans for all floors (drawn to scale, $\frac{1}{4}''=1'$ preferred);
- b. House orientation on site plan;
- c. Scalable elevations for front, rear, left, right;
- d. Height, grade to ridge;
- e. Streetscape comparison showing heights of two flanking houses on each side;
- f. Height from grade to first floor level at all four corners;
- g. Height from grade or finished floor line to eaves at all four corners;
- h. Ceiling heights of each floor, indicating if rough or finished;
- i. Height of space between the ceiling and finished floor above;
- j. Two people of 5'-6" and 6' height shown;
- k. Landscaping plan

6. Additions

- a. Placement shown on elevations and floor plan;
- b. Visibility from rights-of-way and paths;
- c. Photos of all facades;
- d. Design proportioned to main house;
- e. Landscaping plan;
- f. Materials and their combinations

7. Roof Plan

- a. Shape and pitch of roof;
- b. Roofing material;
- c. Overhang;
- d. Louvers and vents;
- e. Chimney height and material

8. Dormers

- a. Construction details provided;
- b. Shape and size of dormer (show dimensions on drawings);
- c. Overhang;
- d. Size of window(s), with nominal size of sash (show dimensions on drawings)

9. Skylights

- a. Profile;
- b. Visibility from right-of-way;
- c. Material (plastic lens or glass);
- d. Shown in plan and elevation to scale

10. Façade

- a. Consistency in style;
- b. Materials and their combinations
 - brick size and color
 - stone type and color
 - fiber-cement (e.g., Hardie-plank) or wood siding
 - shake or shingle
 - other
- c. Height of foundation at corners;
- d. Ceiling heights comparable to area of influence: basement, first floor, second floor;
- e. Detailing: soldier course, brackets, fascia board; water table;
- f. Height from grade to roof ridge;
- g. Dimensions, proportions and placement of windows, doors

11. Entrance

- a. Height and width of door;
- b. Design of door (e.g., 6-panel, craftsman);
- c. Material of door;
- d. Overhang;
- e. Portico height;
- f. Size and height of columns or posts;
- g. Railing

12. Windows

- a. Consistent with original as well as the area of influence;
- b. Size and proportion similar to original;
- c. Pane orientation and size similar to original;
- d. Type (e.g., double hung, casement);
- e. Fenestration on walls visible from right-of-way;
- f. Simulated divided light (SDL) or true divided light (TDL): location of muntins between the glass, behind the glass or permanently affixed on exterior;
- g. Material of window and any cladding;
- h. Width of muntins compared to original (show dimensions on drawings);
- i. Shutters or canopies
- j. Dimensions of windows and doors.

13. Materials

- a. Show all materials and label them on drawings;
- b. Provide samples of brick or stone;
- c. Provide samples if new or unusual materials

14. Garages / Accessory Buildings

- a. Visibility from street;
- b. Placement on site;
- c. Scale, style appropriate for house;
- d. Show dimensions on drawings;
- e. Materials;
- f. Square footage appropriate for lot size;
- g. Garage door size and design
- h. Show height from grade to eaves and to top of roof

15. Demolitions


- a. Provide documentation from engineer concerning feasibility of rehabilitation;
- b. Provide photographs of structure to be demolished;
- c. Provide plan for proposed redevelopment



EXISTING FRONT ELEVATION



EXISTING REAR ELEVATION

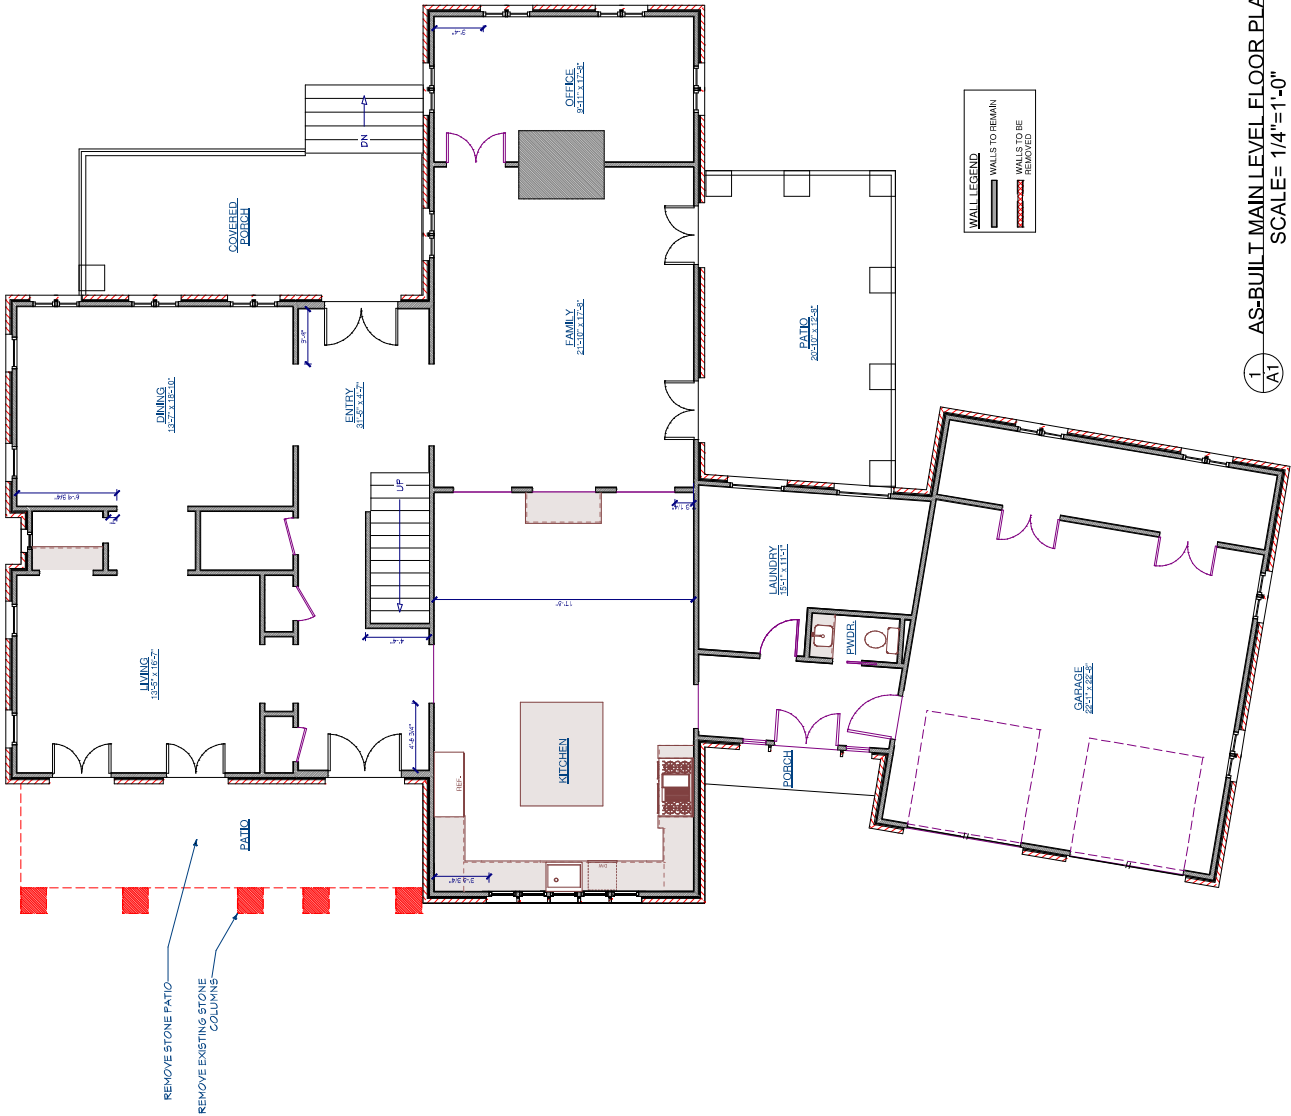

1 AS-BUILT MAIN LEVEL FLOOR PLAN
A1 SCALE= 1/4"=1'-0"

GOVE RESIDENCE
2081 EAST LAKE ROAD
ATLANTA, GA. 30307

NUALLA RESIDENTIAL DESIGN, LLC
P.O. BOX 727
DECATUR, GEORGIA 30031
404.934.8787
DATE: 12-11-23
SCALE: AS NOTED

A7
RELEASED FOR CONSTRUCTION


2 AS-BUILT ROOF PLAN
A2 SCALE= 1/8"=1'-0"





1. PROPOSED MAIN LEVEL FLOOR PLAN
A5 SCALE= 1/4"=1'-0"


1
A6
PROPOSED ROOF PLAN
SCALE= 1/4"=1'-0"

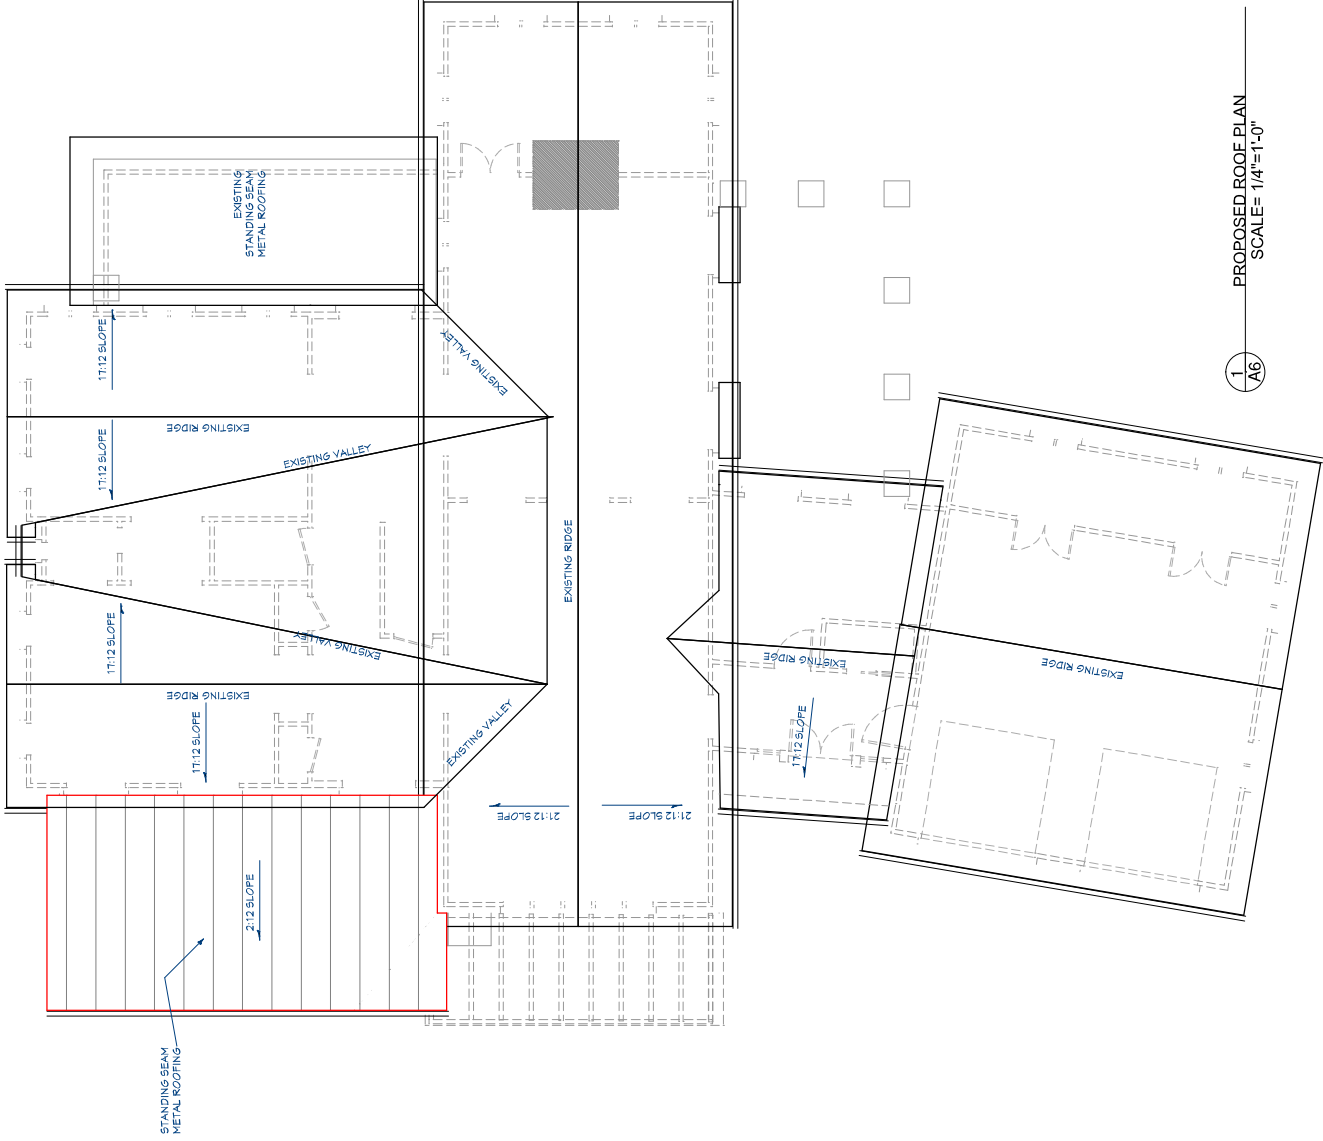


NUALLA RESIDENTIAL DESIGN, LLC
P.O. BOX 727
DECATUR, GEORGIA 30031
404.934.8787
DATE: 12-11-23
SCALE: AS NOTED

GOVE RESIDENCE
2081 EAST LAKE ROAD
ATLANTA, GA. 30307

Copyright 2023 by Nuala Residential Design, LLC
All rights reserved.
This drawing is the property of Nuala Residential Design, LLC
and is not to be reproduced, stored in a retrieval system, or
transmitted in any form or by any means, electronic, mechanical,
photocopying, recording, or by any information storage and
retrieval system, without the prior written permission of
Nuala Residential Design, LLC.

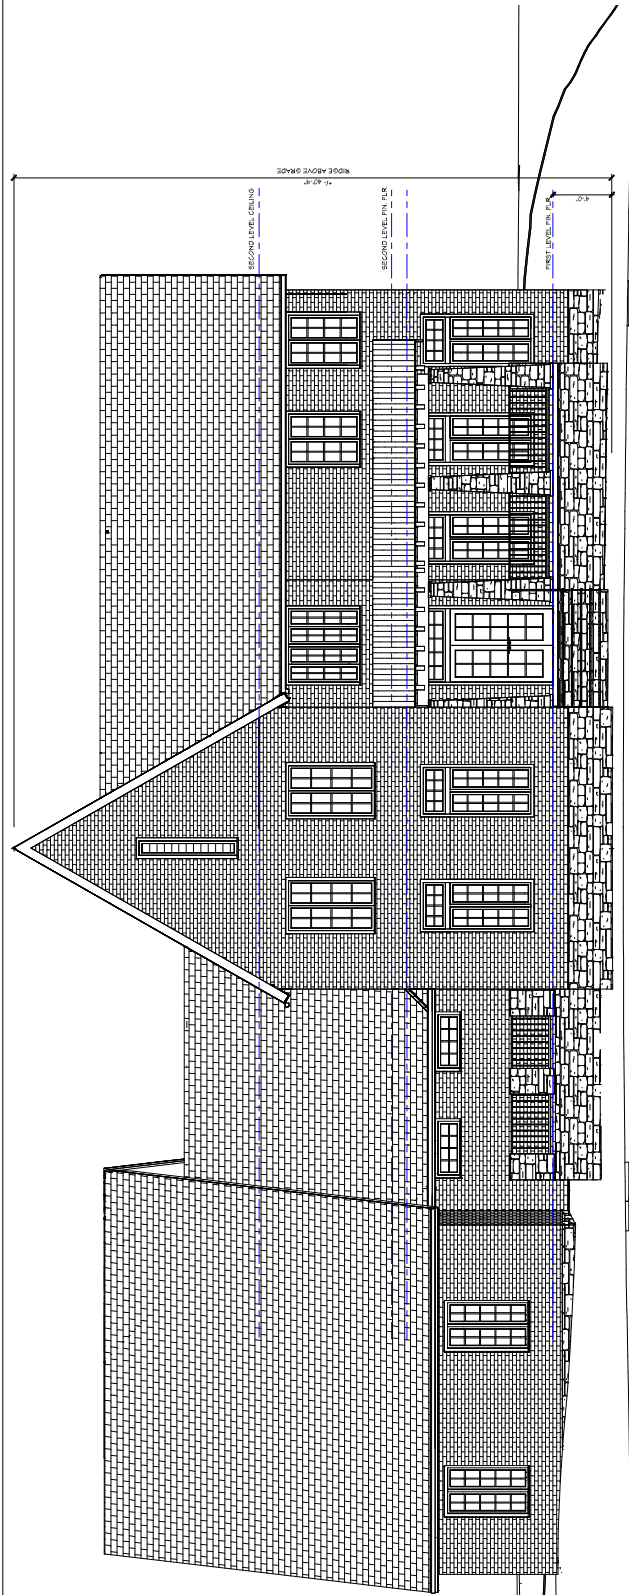

1 AS-BUILT FRONT ELEVATION
SCALE= 1/4"=1'-0"

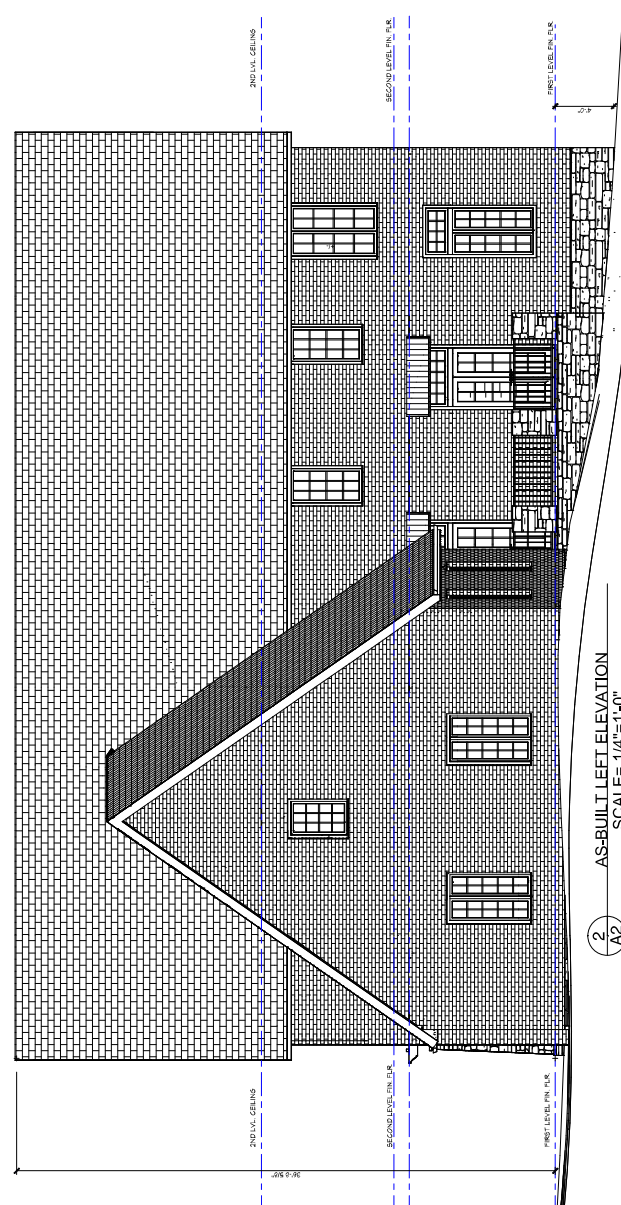

2 AS-BUILT LEFT ELEVATION
SCALE= 1/4"=1'-0"

A3


RELEASED FOR
CONSTRUCTION

NUALLA RESIDENTIAL DESIGN, LLC
P.O. BOX 727
DECATUR, GEORGIA 30031
404.934.8787


DATE:
12-11-23
SCALE:
AS NOTED

GOVE RESIDENCE
2081 EAST LAKE ROAD
ATLANTA, GA. 30307

Copyright 2023 Nuala Residential Design, LLC. All rights reserved. This drawing is the property of Nuala Residential Design, LLC and is not to be reproduced, stored in a retrieval system, or transmitted in any form or by any means, electronic, mechanical, photocopying, recording, or by any information storage and retrieval system, without the prior written permission of Nuala Residential Design, 

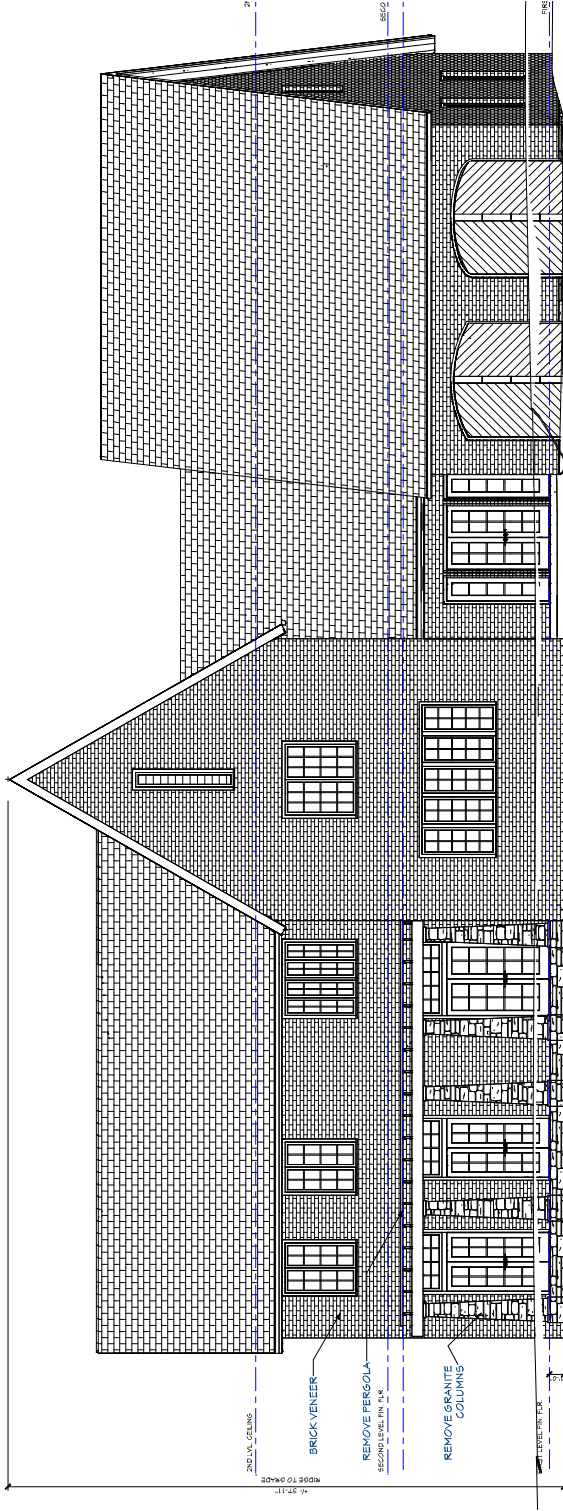

1 AS-BUILT REAR ELEVATION
SCALE= 1/4"=1'-0"

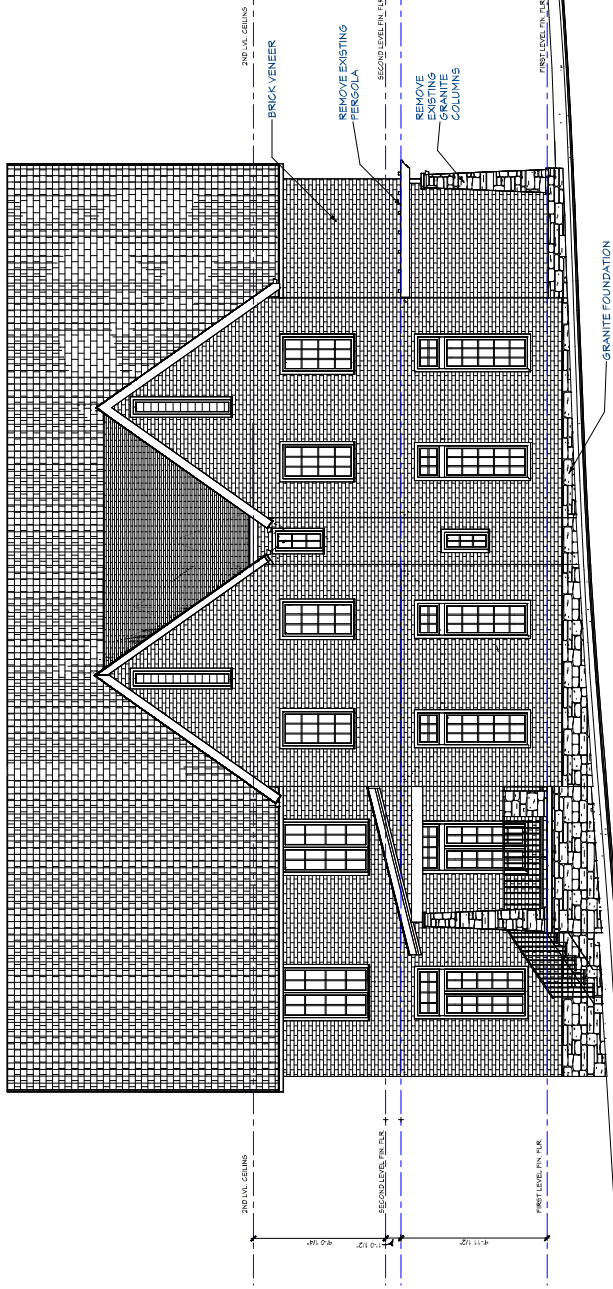

2 AS-BUILT RIGHT ELEVATION
SCALE= 1/4"=1'-0"


NUALIA RESIDENTIAL DESIGN, LLC
P.O. BOX 727
DECATUR, GEORGIA 30031
404.934.8787
DATE: 12-11-23
SCALE: AS NOTED

A4

RELEASED FOR CONSTRUCTION

GOVE RESIDENCE
2081 EAST LAKE ROAD
ATLANTA, GA. 30307

GOVE RESIDENCE
2081 EAST LAKE ROAD
ATLANTA, GA. 30307


Nualia Residential Design, LLC
404.934.8787
P.O. BOX 727
DECATUR, GEORGIA 30031

NUALIA RESIDENTIAL DESIGN, LLC


DATE:
12.11.25
SCALE:
AS NOTED

A7


RELEASED FOR
CONSTRUCTION

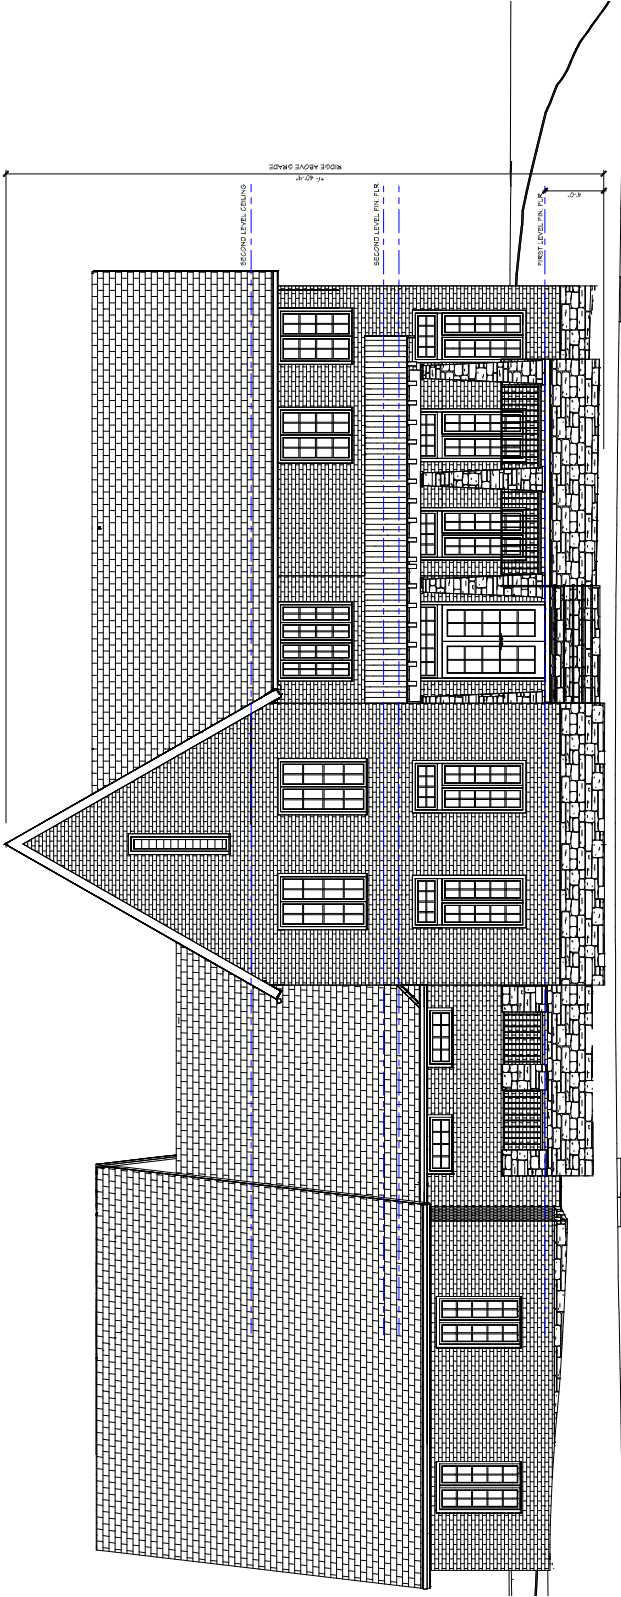


1
A7
PROPOSED FRONT ELEVATION
SCALE= 1/4"=1'-0"

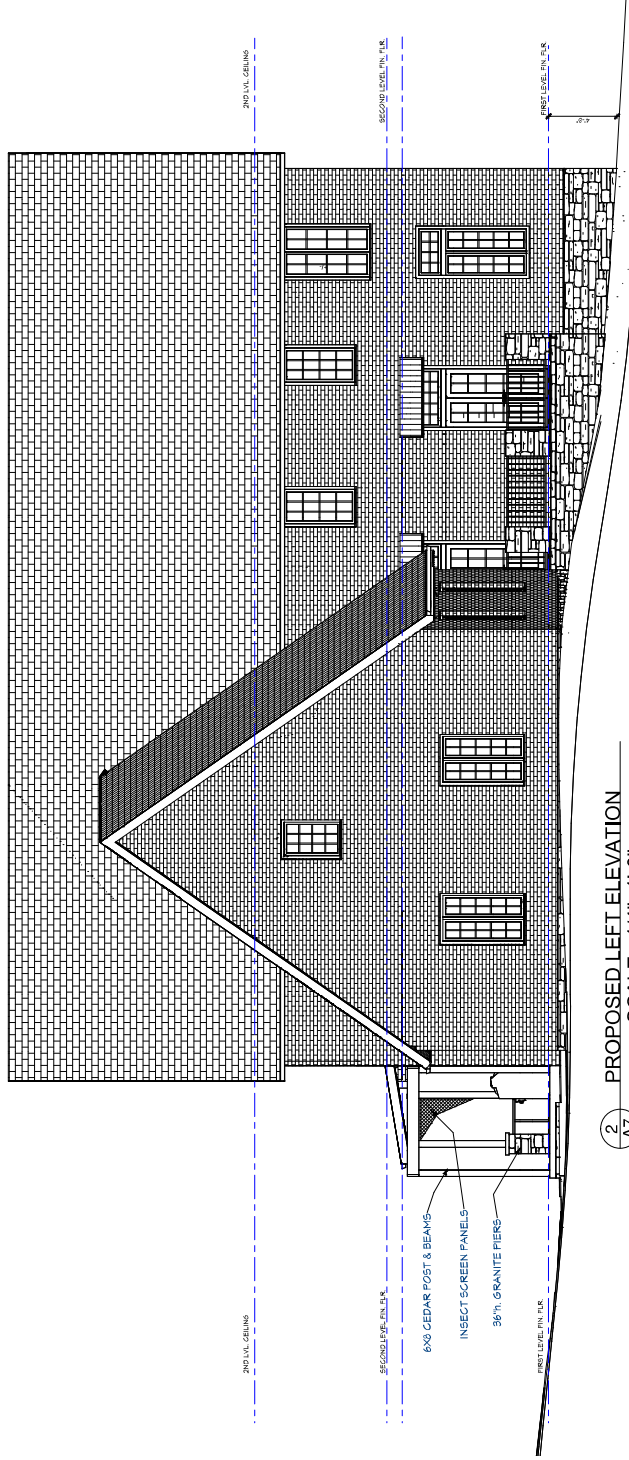

2
A7
PROPOSED LEFT ELEVATION
SCALE= 1/4"=1'-0"

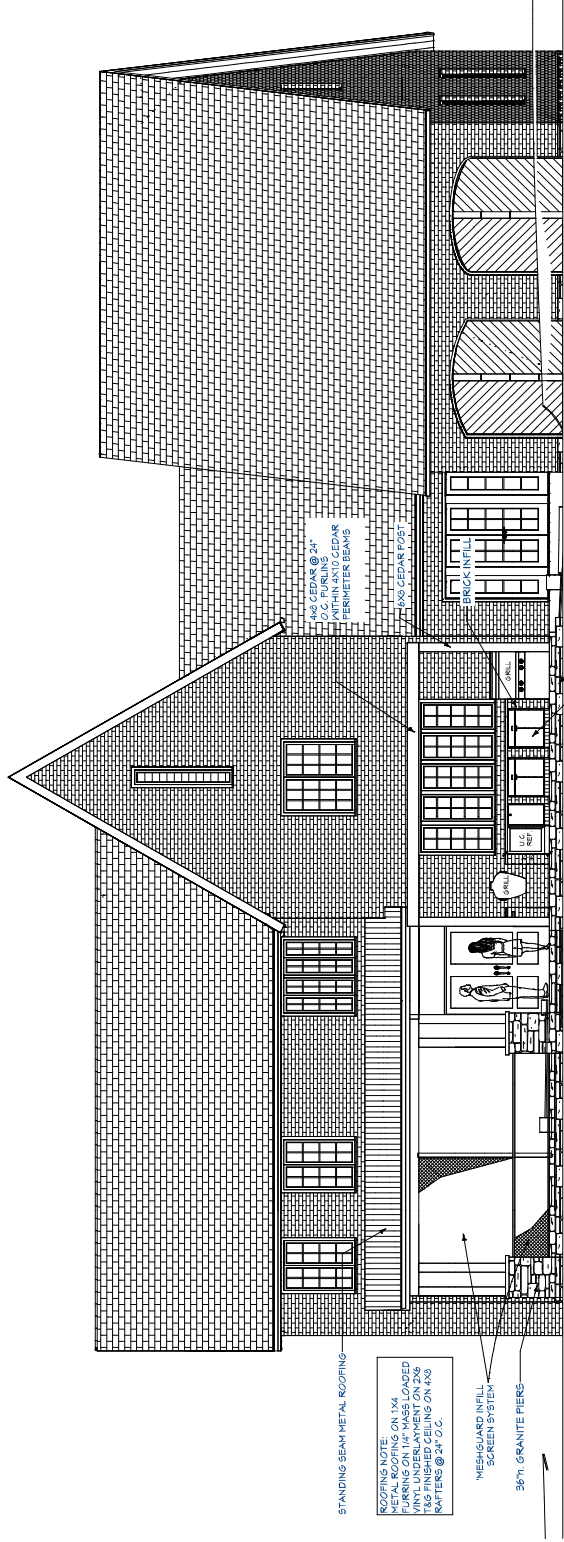

1 PROPOSED REAR ELEVATION
SCALE= 1/4"=1'-0"

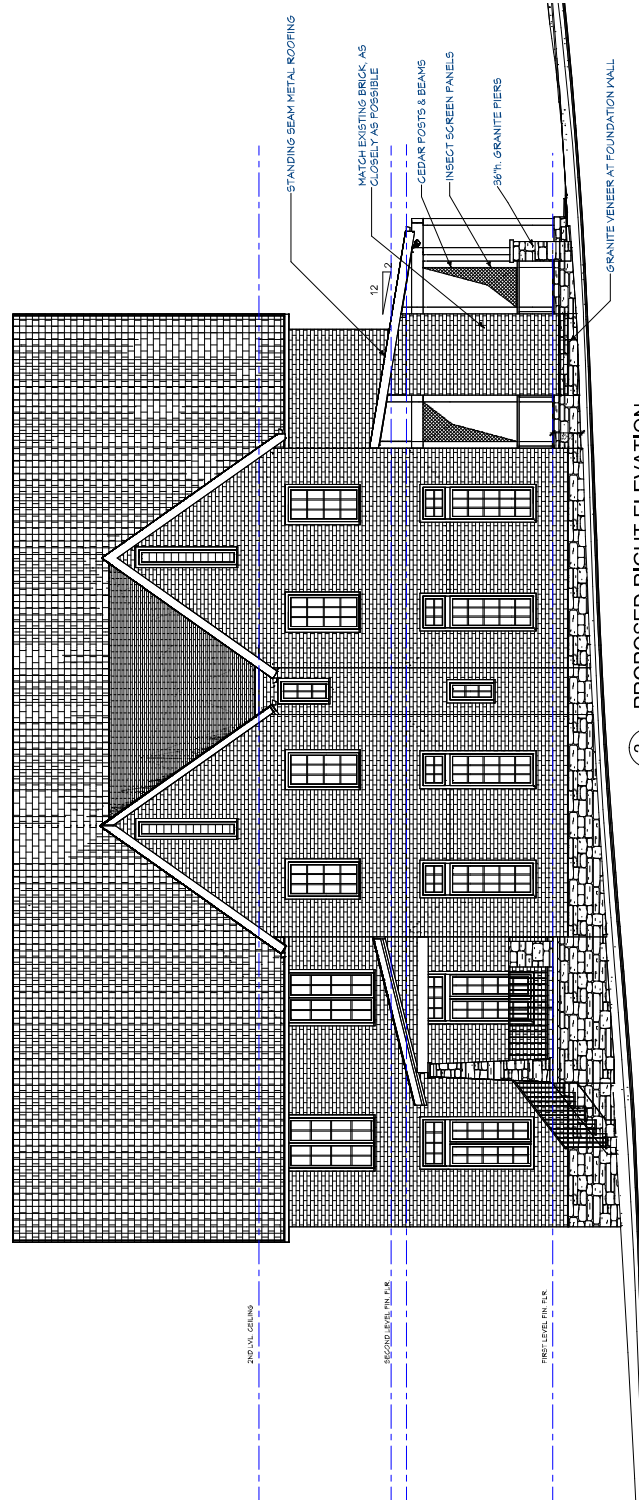

2 PROPOSED RIGHT ELEVATION
SCALE= 1/4"=1'-0"

GOVE RESIDENCE
2081 EAST LAKE ROAD
ATLANTA, GA. 30307

NUALLA RESIDENTIAL DESIGN, LLC
P.O. BOX 727
DECATUR, GEORGIA 30031
404.934.8787

DATE: 12.11.23
SCALE: AS NOTED

A8

RELEASED FOR CONSTRUCTION